

**FLORIDA POLYTECHNIC UNIVERSITY
UNIVERSITY PROCUREMENT
LAKELAND, FL**

**ITB 23-068
CHILLED WATER EXTENSION PROJECT**

DATE: 04/04/2023

ADDENDUM NO: Two (2)


PLEASE NOTE:

The following item(s) are issued to revise the ITB and all associated documents. These item(s) shall have full force and effect as the ITB and all associated documents. Responses to be submitted on the specified response due date shall conform to the additions and revisions listed.

SCOPE CLARIFICATION ADDENDUM

Please use the following information to assist you in estimating your bid for the chilled water supply extension:


- It is our understanding from the civil as-built drawing below, that the existing chilled water supply is a 6" pipe that turns 90 degrees into the vault. This drawing is from 2012 when the campus was built and is believed to be an accurate representation of the as-built conditions.

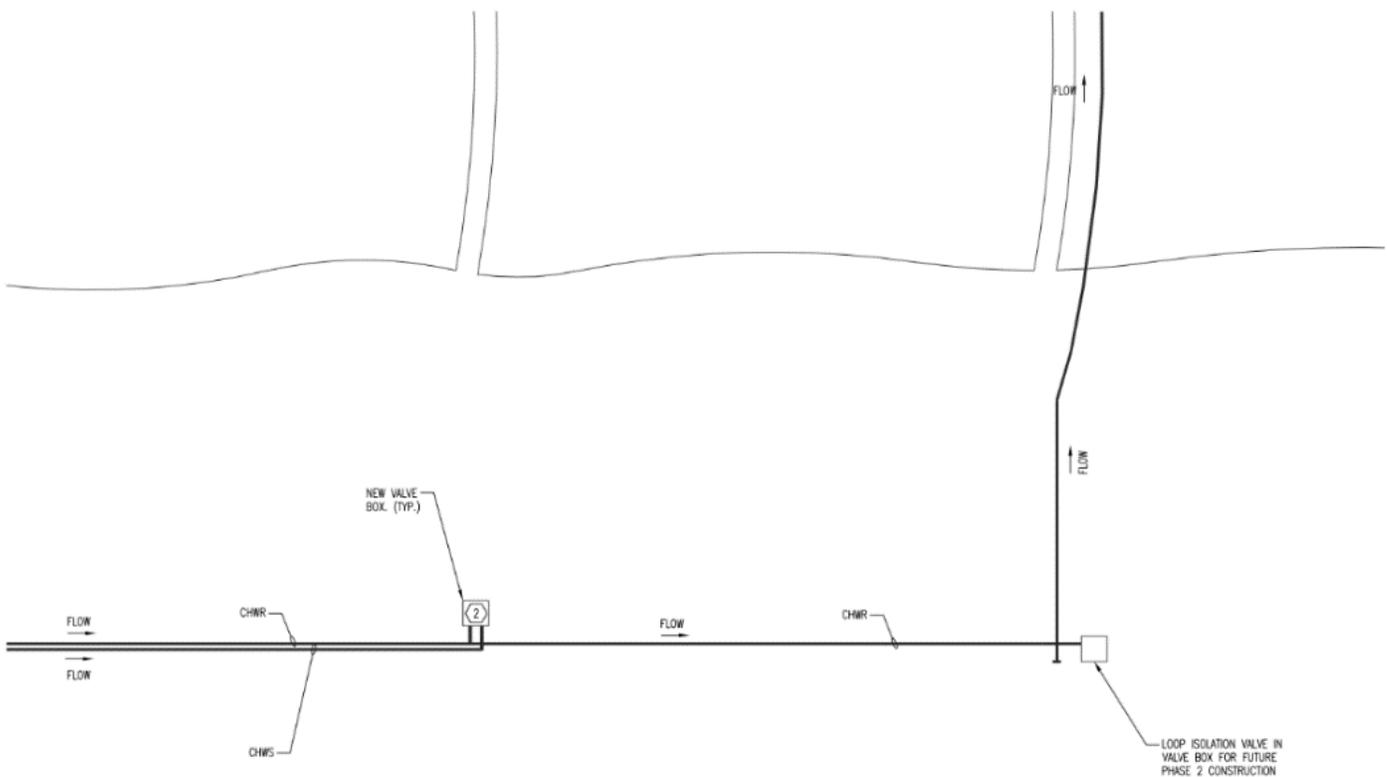


- We have confirmed with the engineers that the new extension could be tied into the existing supply line through the valve located in the vault where the extension will tie into the system. A “T” should be utilized at the valve to allow a tie-in for a future building at that location. The new line would then be routed back around and into the pathway of the existing return line heading south. This is in lieu of hot tapping a “T” in-place of the elbow to extend the supply line. Both are considered viable solutions for the purposes of this ITB.
- The new supply pipe will need to run under the walkway adjacent to the vault where the pipe terminates. The removal and restoration of this walkway should be included in the scope of work.
- The existing vault should be large enough to support the addition of the 6” supply in addition to the 14” return line that is existing, see this revised drawing from the engineers to illustrate the offset location of the two lines to allow clearance.

See the drawing on the following page.

ALLOW FOR ACCESS TO VALVES AND T&P PORTS.

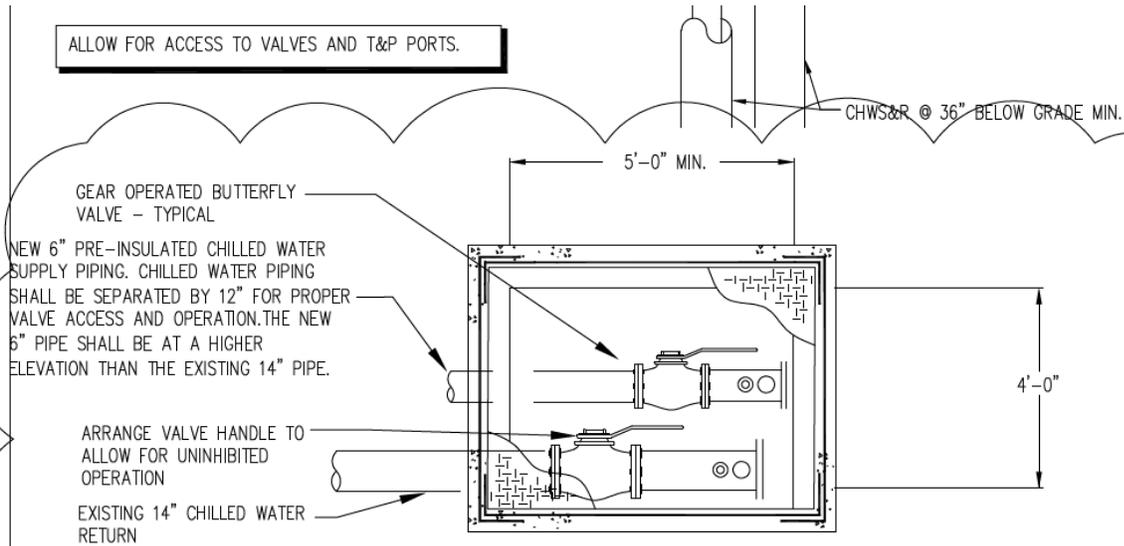

PLAN
NOT TO SCALE

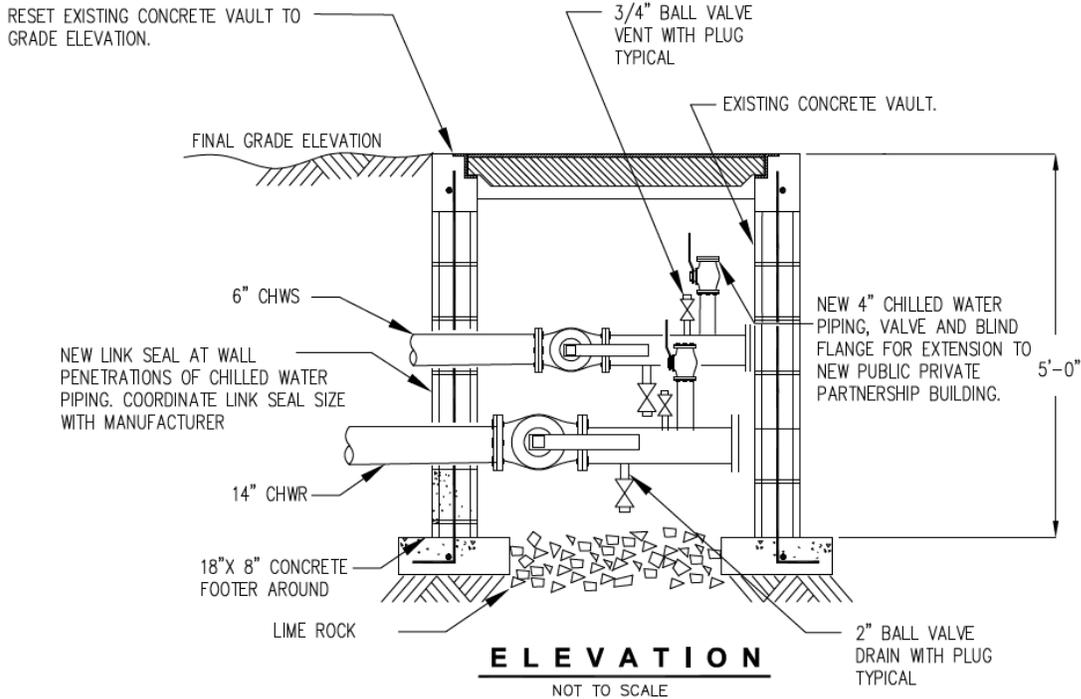

ELEVATION
NOT TO SCALE

VALVE BOX DETAIL
No Scale

4

PIF
No

TY
No

All respondents must acknowledge receipt of this addendum by signing below and submitting this executed document with your response. Failure to execute and return this addendum form may disqualify your firm's response.

This addendum shall become part of your firm's response and the subsequent documents if applicable.

Vendor name: _____

Address: _____

Phone number: _____ Email: _____

Signature: _____